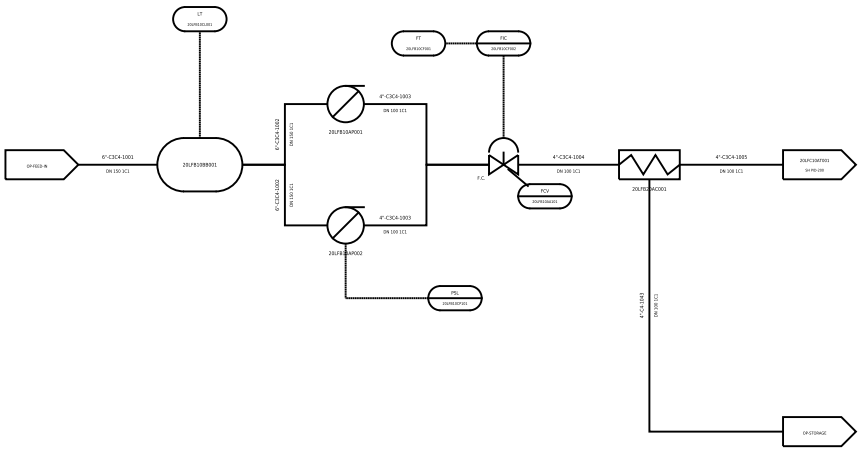


EQUIPMENT AND INSTRUMENT DATA

TAG	ITEM	VALUE
20LFB100AA101	FAIL POSITION	FC
20LFB100AP001	DUTY	running
20LFB100AP002	DUTY	standby
20LFB100B001	SERVICE	C3/C4 mixed feed

REVISIONS

REV	DATE	DESCRIPTION	MOC
A	2017-09-12	Issued for design	-
0	2018-06-20	As-built after commissioning. Added 20LFB50CP101 auto-start for standby feed pump.	-

SYNTHETIC DEMO DATA
NOT A REAL PLANT

MERIDIAN GAS PROCESSING - HARBOR TERMINAL
SYNTHETIC DEMO DATA - NOT A REAL PLANT
UNIT 200 C3/C4 SPLITTER
TITLE: Feed and Preheat
DWG NO: PID-100
REV: 0
DATE: 2018-06-20
DRAWN: Dana Okafor
MOC: -